


Nasland
 4140 Sully Street
 T 800 282 2700
 San Diego, CA 92111
 nasland.com
 Civil Engineering Surveying Land Planning

[illegible]





CUT = 112 CUBIC YARDS
FILL = 3543 CUBIC YARDS
NET = +3431 CUBIC YARDS

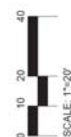

Nasland
 4500 Sutter Street
 San Diego, CA 92111
 760.293.2729
nasland.com
 Civil Engineering Surveying Land Planning

[illegible]

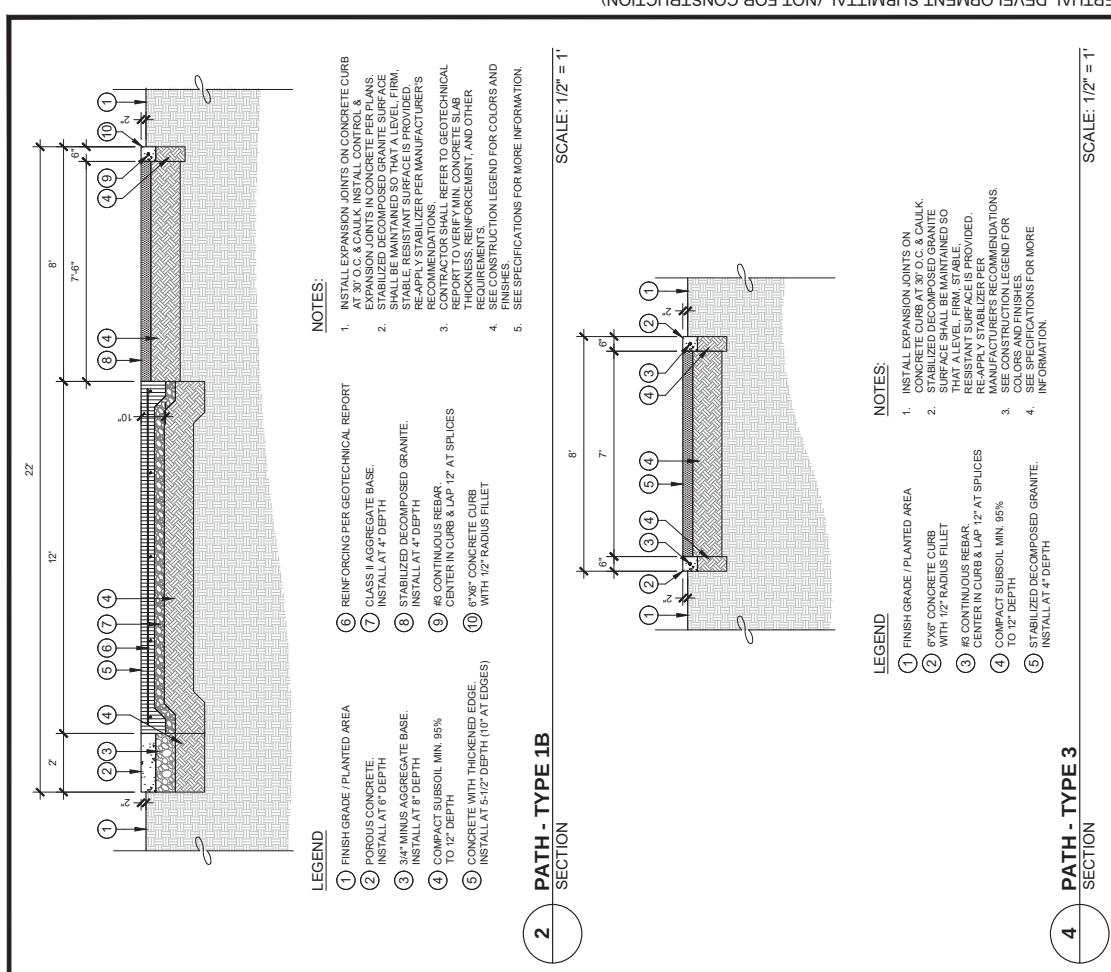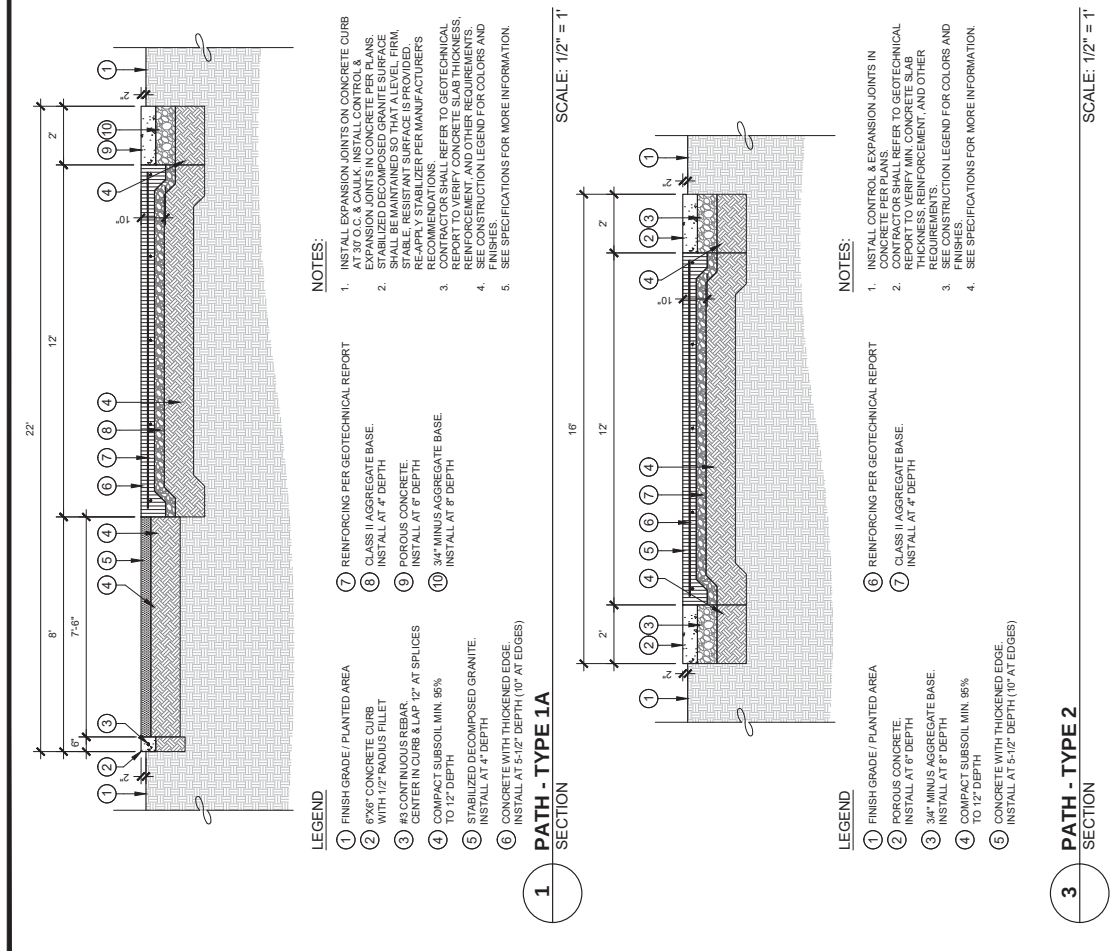



1011 Second Street
San Diego, CA 92101
(619) 234-8877
www.kuasd.com

RECORD DRAWING

DESIGNED BY: ORDER OF RECORD

DATE: ---

NOTES:

THIS DRAWING IS A REDUCED SCALE PRINT OF THE ORIGINAL DRAWING. UTILIZE GRAPHING SCALES TO REDUCE AND ADJUST SCALES ACCORDING TO THE ORIGINAL SCALES SHOWN.

DATE: 2012-27

PROJECT: MARK MCINTIRE

CONTRACTOR: CONSTRUCTION SHARED

DATE / APPROVED: MARK MCINTIRE

DATE: 08/01/2018

AT: MLC-11.0

SHEET: 02 OF 02

CV-2018-02



PORT of SAN DIEGO
A World of Possibilities

SAN DIEGO UNIFIED PORT DISTRICT

SWEETWATER BICYCLE PATH & PROMENADE

LANDSCAPE CONSTRUCTION DETAILS SHEET 1



1011 Second Street
San Diego, CA 92101
(619) 234-8877
www.kuasd.com

RECORD DRAWING

DESIGNED BY: ORDER OF RECORD

DATE: ---

NOTES:

THIS DRAWING IS A REDUCED SCALE PRINT OF THE ORIGINAL DRAWING. UTILIZE GRAPHING SCALES TO REDUCE AND ADJUST SCALES ACCORDING TO THE ORIGINAL SCALES SHOWN.

DATE: 2012-27

PROJECT: MARK MCINTIRE

CONTRACTOR: CONSTRUCTION SHARED

DATE / APPROVED: MARK MCINTIRE

DATE: 08/01/2018

AT: MLC-11.0

SHEET: 02 OF 02

CV-2018-02



PORT of SAN DIEGO
A World of Possibilities


SAN DIEGO UNIFIED PORT DISTRICT

SWEETWATER BICYCLE PATH & PROMENADE


LANDSCAPE CONSTRUCTION DETAILS SHEET 1

- LEGEND**
- 1 PATH PER PLAN
 - 2 CONCRETE ABUTMENT. REFER TO CONCRETE ABUTMENT ENLARGEMENT
 - 3 TOP OF BRIDGE DECK
 - 4 REVISED GRADE PER PLAN
 - 5 REVISED CHANNEL PER PLAN
 - 6 REFER TO CONCRETE ABUTMENT ENLARGEMENT
 - 7 3/4" X 18" ANCHOR RODS (4)
 - 8 EX GRADE
- NOTES:**
- 1. ELEVATIONS AT THE TOP OF ABUTMENTS TO BE THE SAME ON BOTH SIDES OF THE BRIDGE
 - 2. ALL CONCRETE ABUTMENTS TO BE DONE WITH GOOD CLEAN, FREE-DRAINING GRANULAR MATERIAL PLACED IN 8" LOOSE LIFTS AND COMPACTED TO 95% OF MAXIMUM DRY WEIGHT
 - 3. GROUNDWATER MAY BE ENCOUNTERED. THE EXCAVATION SHOULD BE PUMPED DRY BEFORE ANY CONCRETE IS PLACED OR FORMWORK AND CONCRETE
 - 4. INSTALL PER BRIDGE MANUFACTURERS RECOMMENDATIONS, DETAILS AND REVISIONS
 - 5. REFER TO GEOTECHNICAL REPORT FOR SOILS AND ABUTMENT
 - 6. REFER TO STRUCTURAL PLANS FOR REINFORCEMENT AND CONFIGURATION

- LEGEND**
- 13 FINISH GRADE, SLOPE AND GRADIENTS VARY. SEE GRADING PLANS
 - 14 1-1/2" DIA. X 16-GAUGE SECONDARY LINE POST. USE LOOP CAPS FOR GRADE CONDITIONS.
 - 15 FASTER CHAINLINK FABRIC TO SECONDARY LINE POSTS WITH WIRE CLIPS @ 8" O.C. MAX.
- NOTES:**
- 1. INSTALL PER MANUFACTURER'S RECOMMENDATIONS.
 - 2. REFER TO MANUFACTURER'S LEGEND FOR COLORS AND FINISHES OF ALL FENCE COMPONENTS.

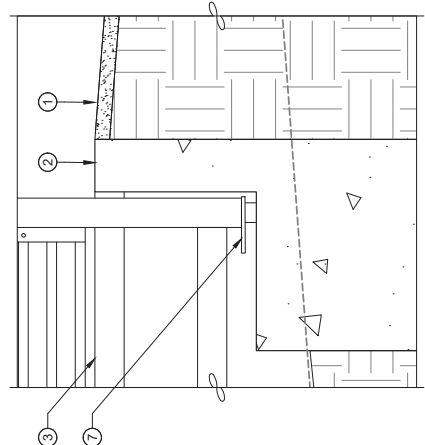

CONCRETE ABUTMENT ENLARGEMENT
SCALE 1" = 1'

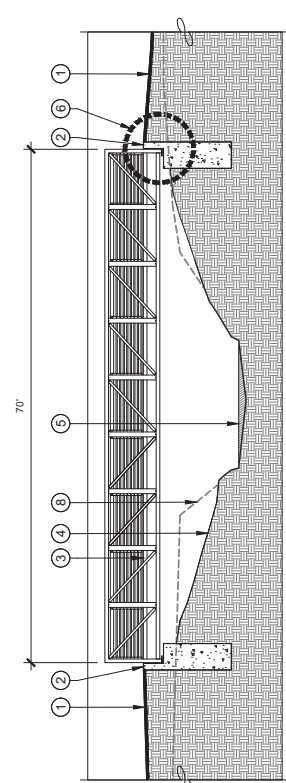


BRIDGE | SCALE 1/8" = 1'

1 PRE-MANUFACTURED BRIDGE
SECTION

SCALE: VARIES

LEGEND

- 1 POST DOME CAP
- 2 RAIL END
- 3 2 1/2" DIA. X 16-GAUGE CORNER/ END (TERMINAL) ROUND POST
- 4 3/8" DIA. X 16-GAUGE LINE (INTERMEDIATE) ROUND POST - USE LOOP CAPS FOR FENCE ON RELATIVE FLAT GRADE CONDITIONS
- 5 TENSION BAND
- 6 TENSION BAR
- 7 2" X 9-GAUGE CHAINLINK FABRIC
- 8 9-GAUGE (MIN) TENSION WIRE
- 9 TENSION WIRE CLIPS @ 21" O.C. MAX.
- 10 1 1/2" DIA. X 16-GAUGE TOP RAIL
- 11 FENCE TIES @ 21" O.C. MAX.
- 12 CONCRETE FOOTING - 4 TIMES OUTSIDE DIAMETER OF POST (MIN). PROVIDE 2" CROWN

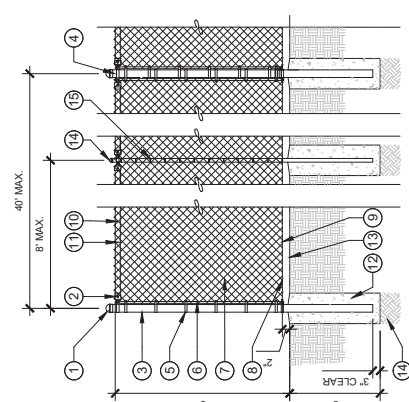

3 ENVIRONMENTAL FENCE
SECTION

SCALE: 1/2" = 1'

DETAIL IN PROGRESS

2 BRIDGE RAILING
PLAN | SECTION

SCALE: N.T.S.



RECORD DRAWING

DESIGNED BY: **ktua**

DATE: **2012-27**

PROJECT: **MARK MCINTIRE**

CONTRACTOR: **MARK MCINTIRE**

CONSTRUCTION: **COMPLETED**

REVISIONS: **0**

PORT OF SAN DIEGO

SWEETWATER BICYCLE PATH & PROMENADE

LANDSCAPE CONSTRUCTION DETAILS SHEET 2

DATE: **08/01/2018**

BY: **W.C. MCINTIRE**

SCALE: **1/2" = 1'**



FORMS+SURFACES - BALANCE BENCH



FORMS+SURFACES - BALANCE BENCH



FORMS+SURFACES - KNIGHT BENCH



FORMS+SURFACES - KNIGHT BENCH



MAGLIN - MLB970 SERIES



MAGLIN - MLB970 SERIES



MAGLIN - SCB1600 SERIES



MAGLIN - SCB1600 SERIES

SEATING

1 SUCH AS SITE FURNISHINGS
IMAGERY



FORMS+SURFACES - DISPATCH LITTER RECEPTACLE



MAGLIN - MRC1403 SERIES

LITTER RECEPTACLES



RECORD DRAWING

DESIGNED BY: _____

DATE: _____

THIS DRAWING IS A REDUCED SCALE PRINT OF THE ORIGINAL DRAWING. IT IS NOT TO BE USED FOR CONSTRUCTION. ALL DIMENSIONS AND NOTES SHALL BE BASED ON THE ORIGINAL DRAWING.

DATE: 2018-07-10

PROJECT: SWEETWATER BICYCLE PATH & PROMENADE

DATE: 2018-07-10

DATE: 2018-07-10

SAN DIEGO UNIFIED PORT DISTRICT
SWEETWATER BICYCLE PATH & PROMENADE
LANDSCAPE CONSTRUCTION DETAILS SHEET 3

DATE: 08/01/2018
PROJECT NO: 15-0
SHEET NO: 3
REV: 0